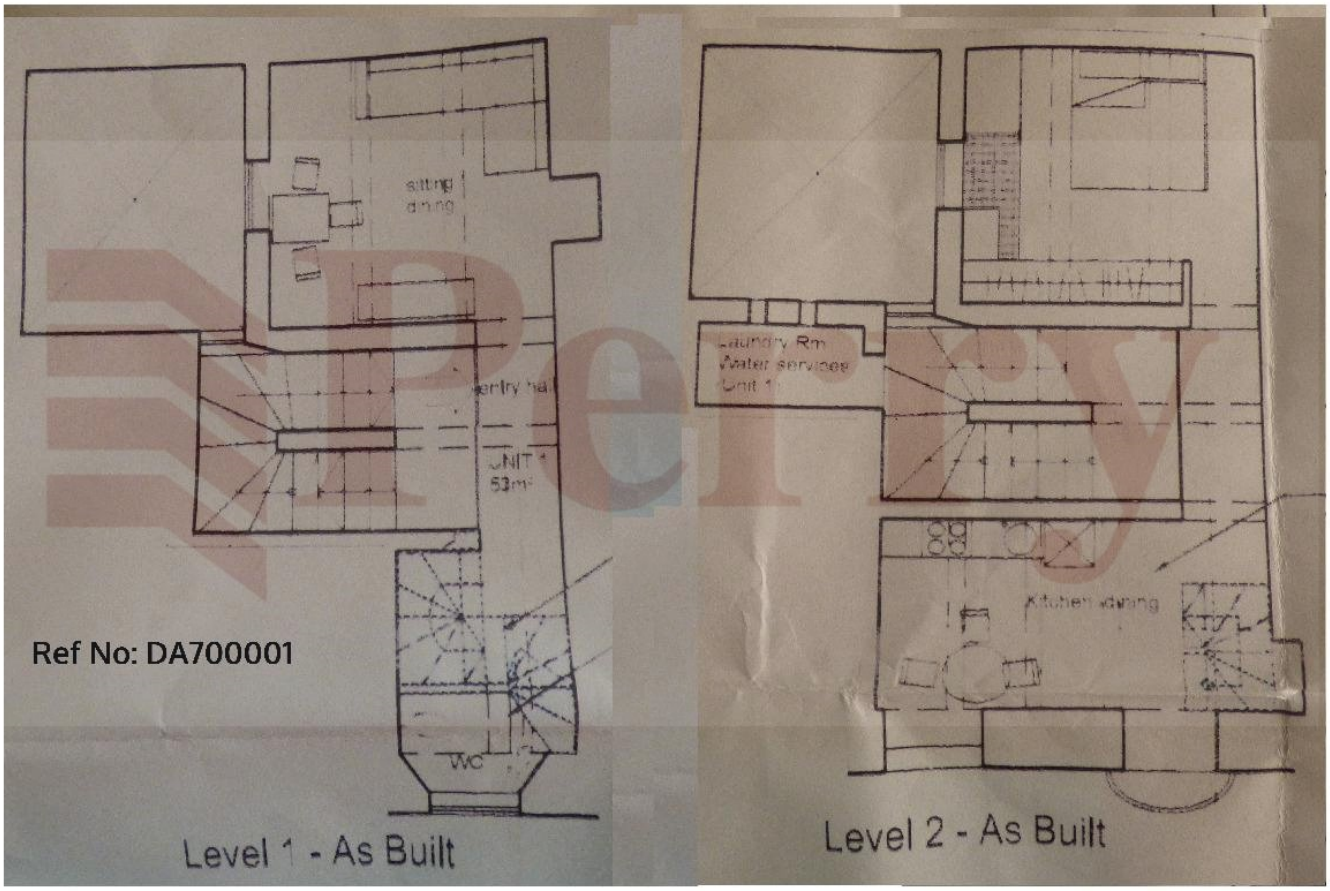
sitting
dining
entry hall
UNIT 1
53m²
WC
Ref No: DA700001
Level 1 - As Built
Laundry Rm
Water services
Unit 1
Kitchen/dining
Level 2 - As Built